



814100mN

814200mN


814300mN

814400mN

406300mE

406400mE

406500mE

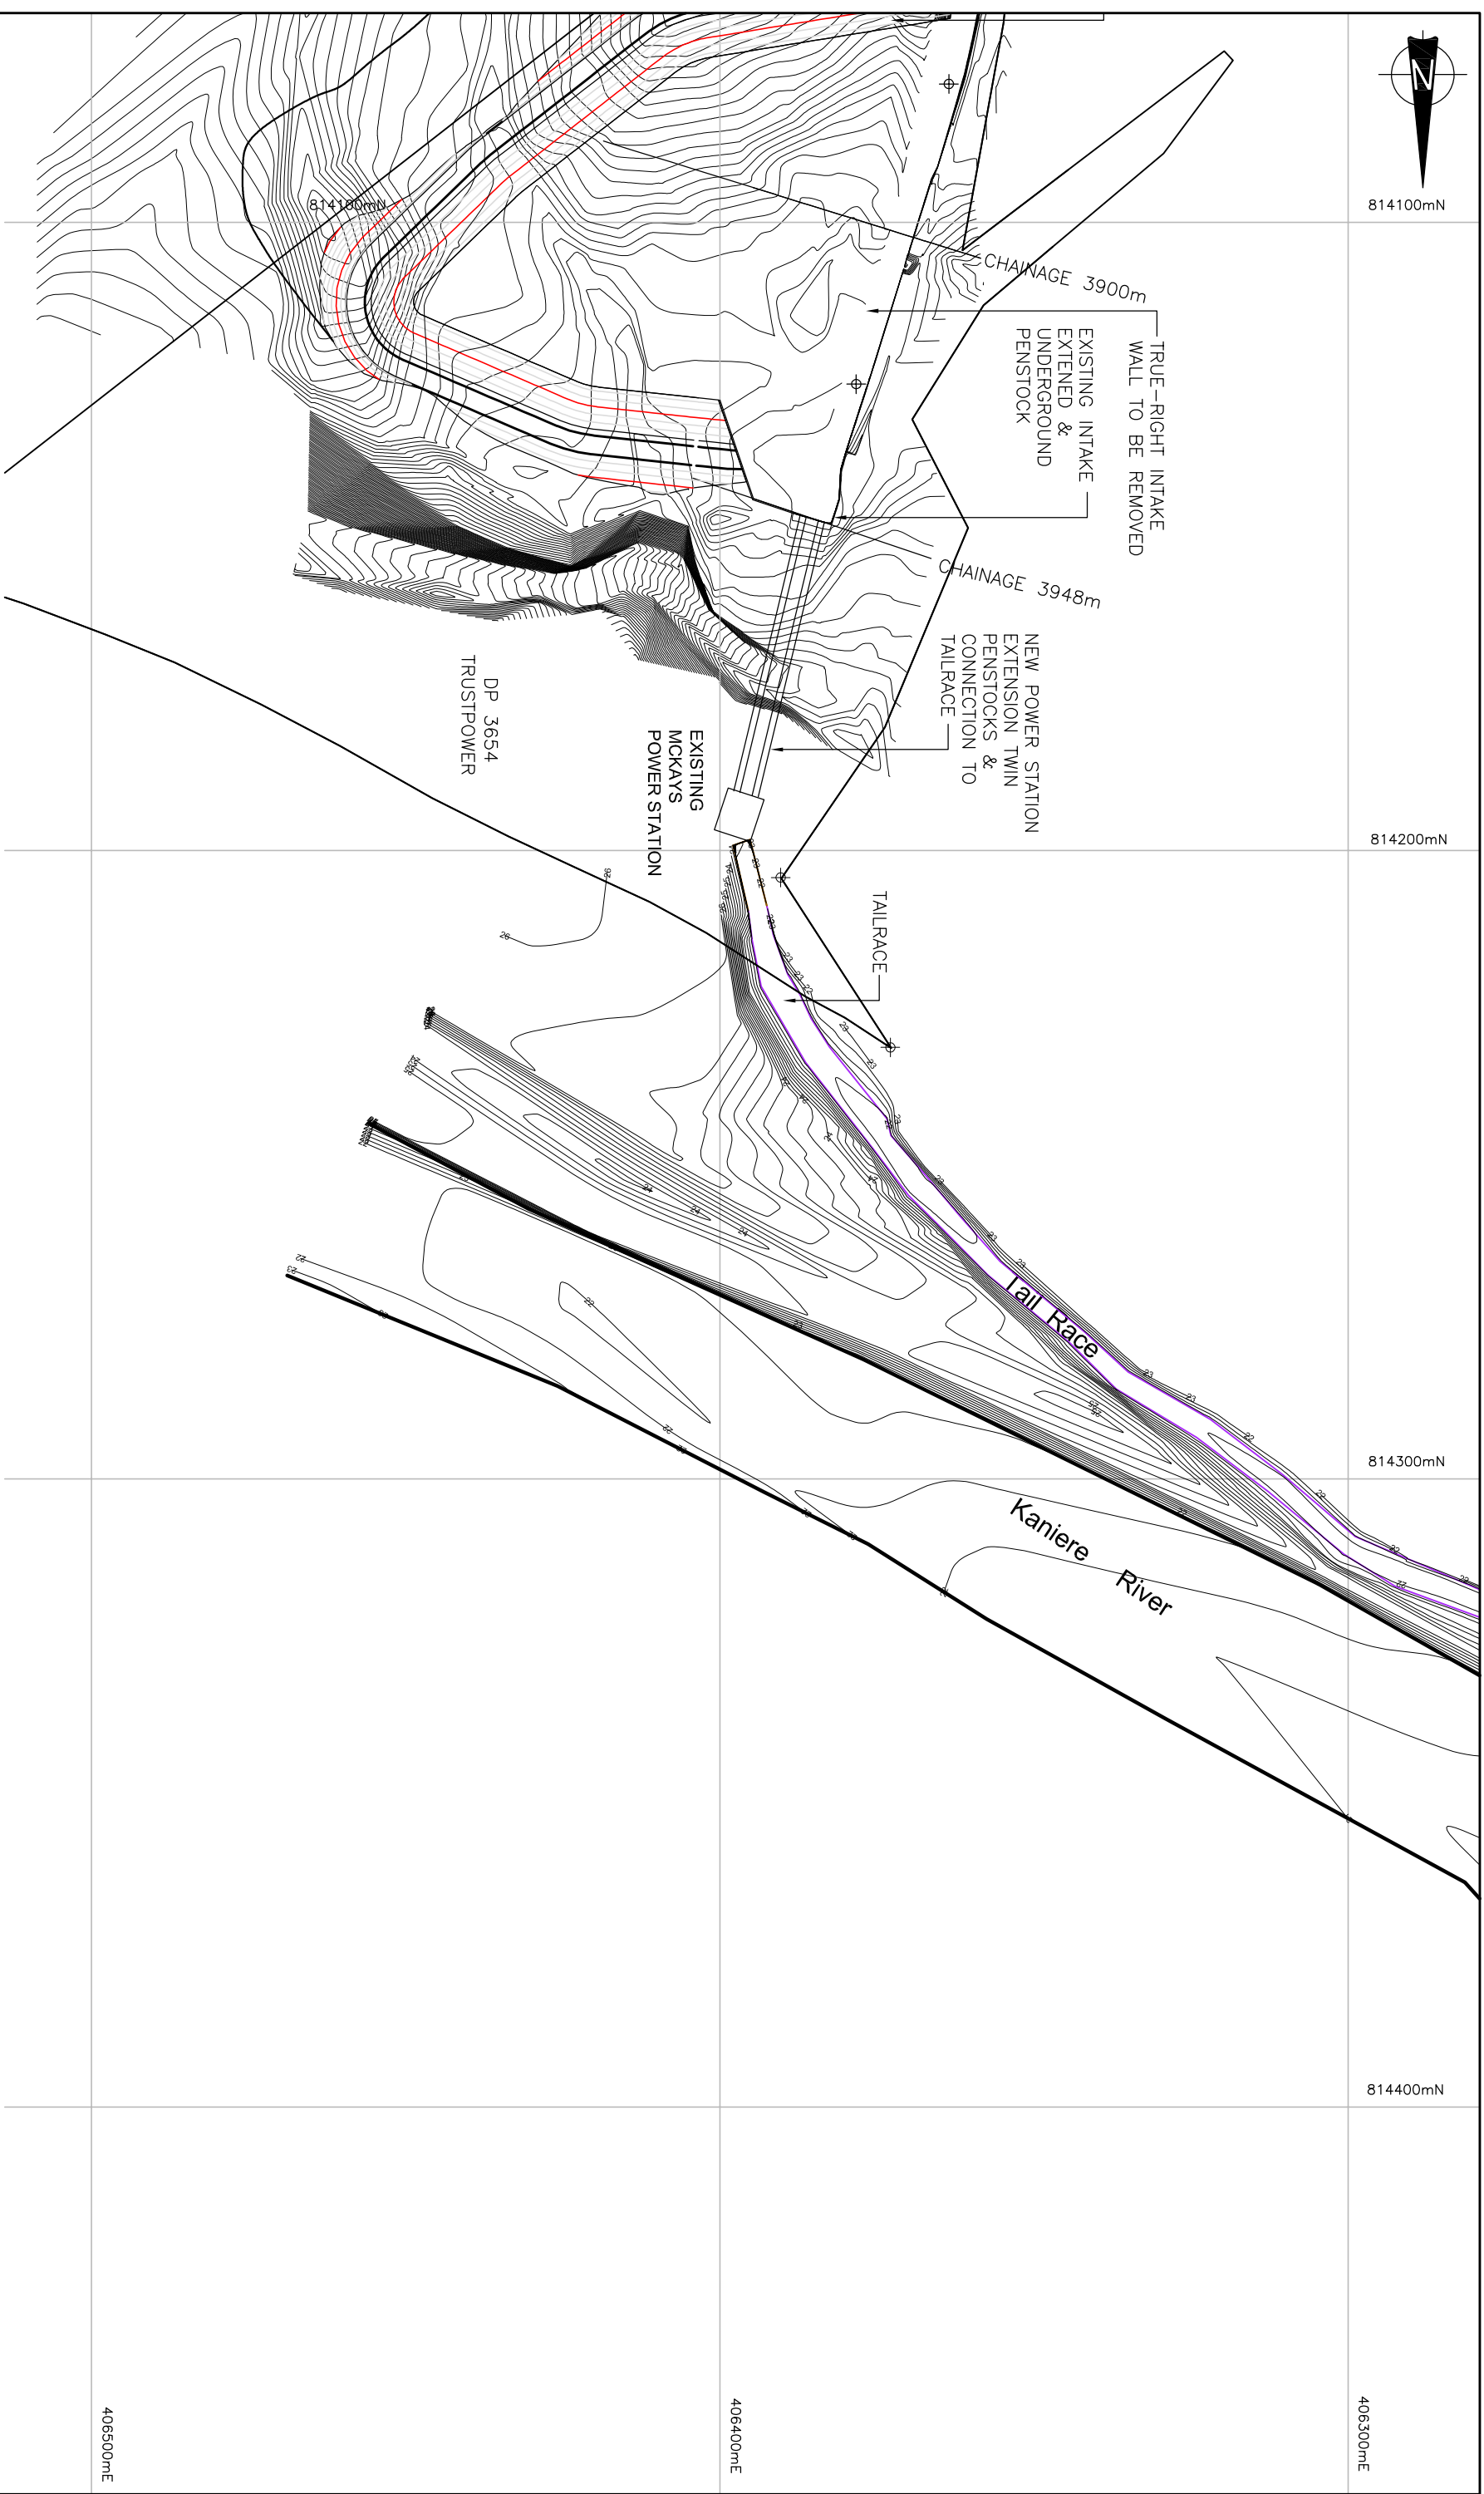

NOTE:-

FOR REFERENCE SEE DWG 08MKY/KWU-100
Φ INTERMEDIATE 25m CHAINAGE POINT

2	HEADPOND AMENDED	HN 2.9.10	DRAWN	CHECKED	DESIGN CHECKED	PPR
1	DRAWING AMENDED	HN 17.8.10	HN			
0	FIRST ISSUE		DATE DRAWN			
REV	DESCRIPTION	BY	DATE			

APPROVED FOR ISSUE:
DATE: / /



RILEY
CONSULTANTS

P.O. BOX 4355
CHRISTCHURCH
TEL. 03-3794402
FAX. 03-3794403



TITLE

TRUSTPOWER LTD
MCKAYS CREEK HYDRO SCHEME - 8 CUMEC ENHANCEMENT
CANAL LONG-SECTION AS-BUILT - SHEET 14 of 14

NOT FOR CONSTRUCTION

GAOFILE	08MKY/KWU-100&110t123
SCALES (A3)	AS SHOWN
ACENZ	
DRAWING No.	08MKY/KWU-123
REV.	2